



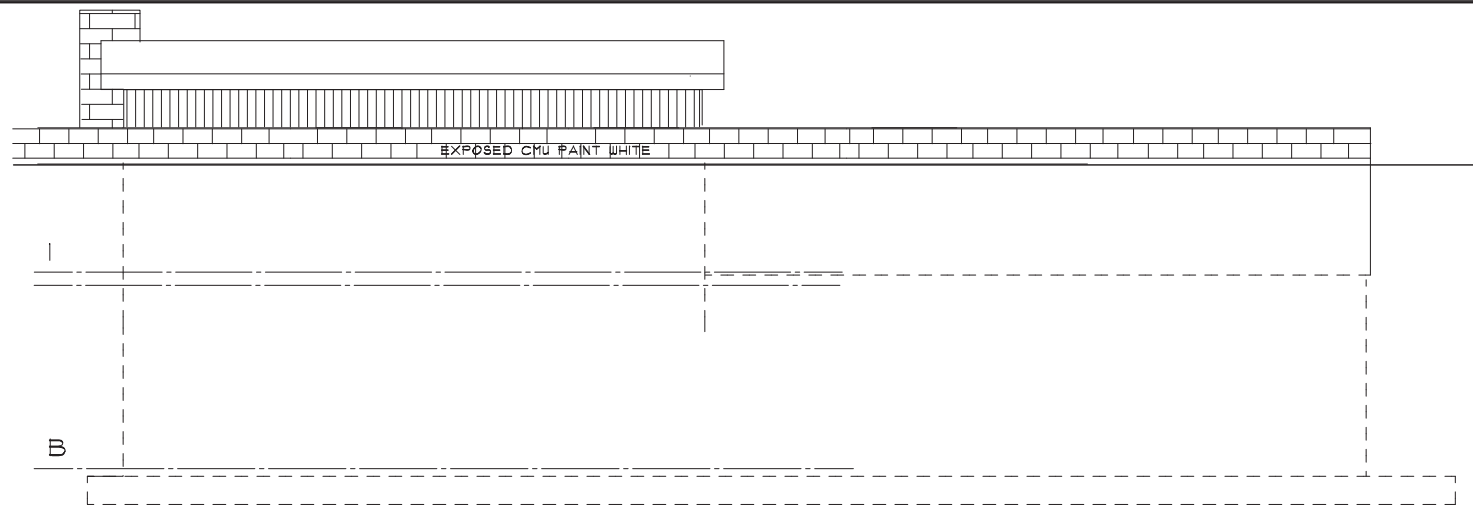


SOUTH ELEVATION

SCALE: 1/4"=1'-0"

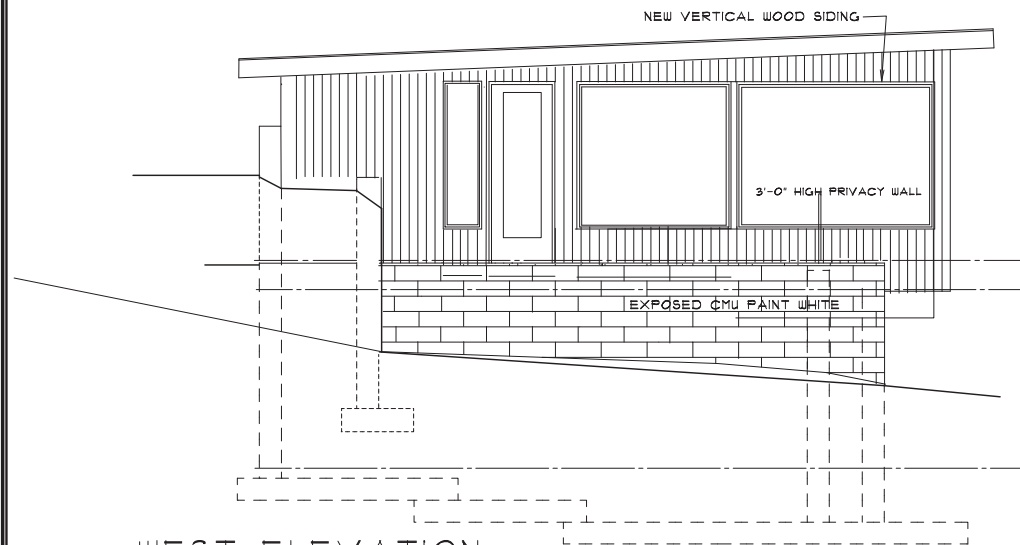


WEST ELEVATION

SCALE: 1/4"=1'-0"

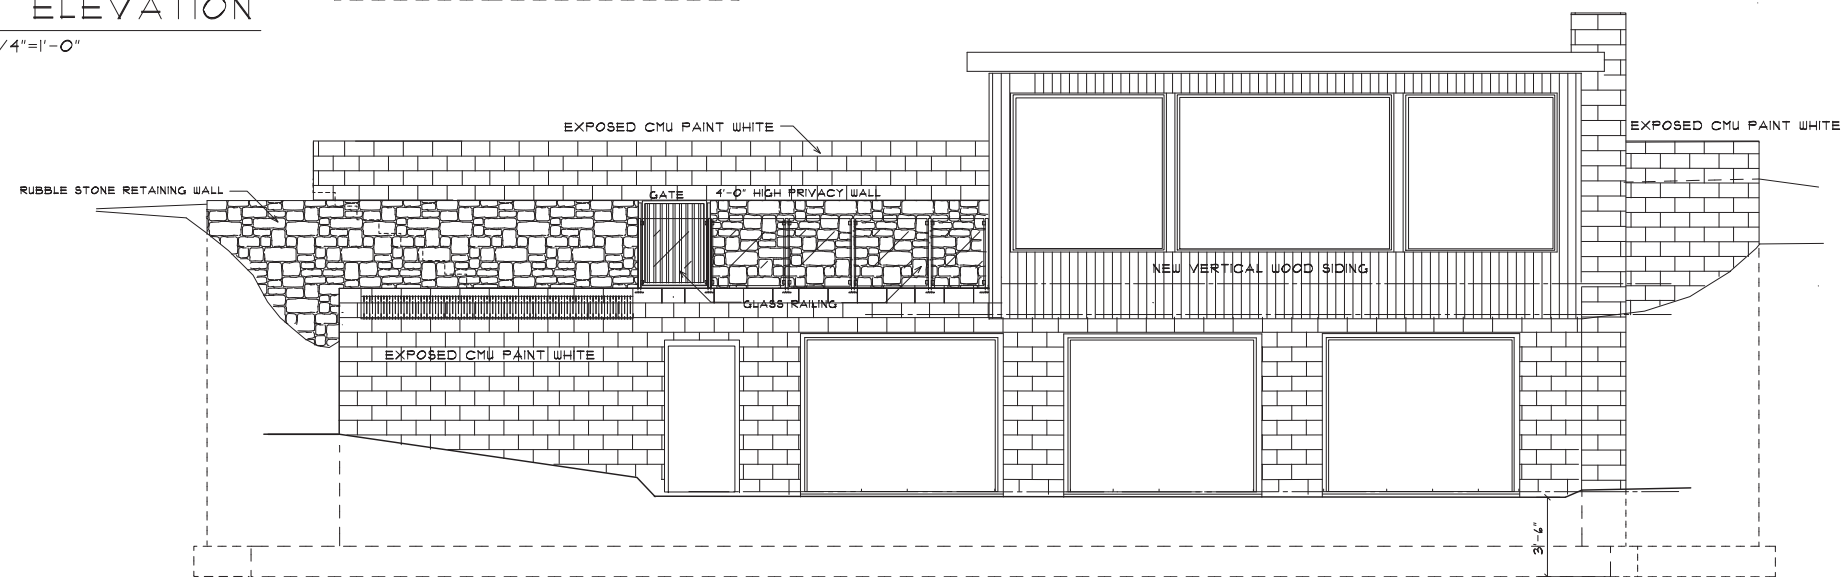


NORTH ELEVATION

SCALE: 1/4"=1'-0"

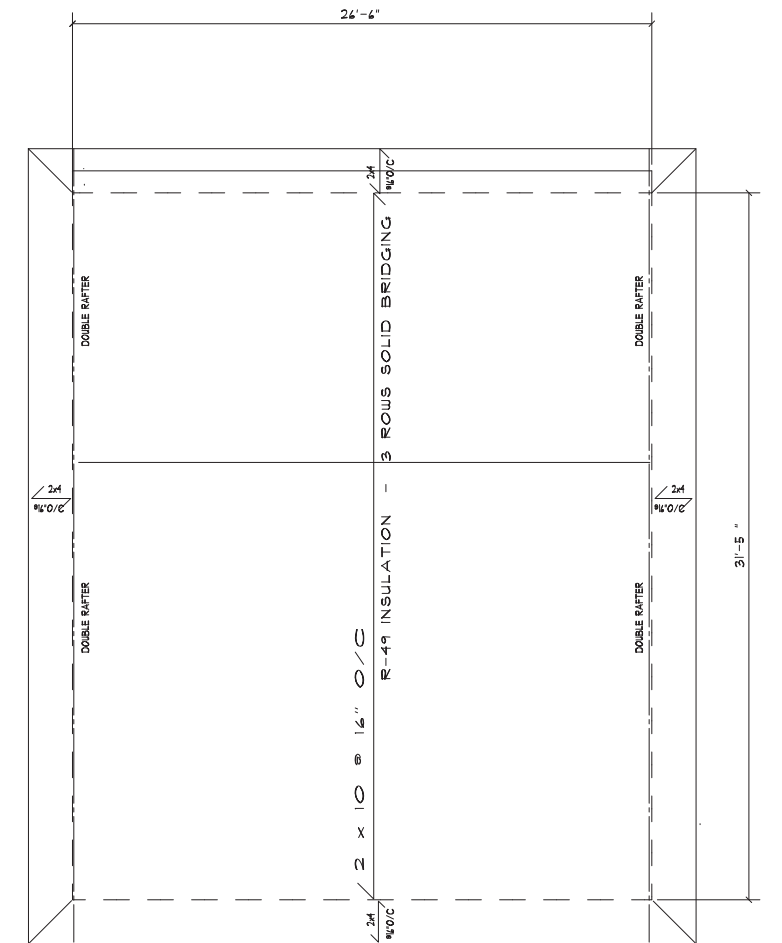

ROOF FRAMING PLAN

SCALE: 1/4"=1'-0"

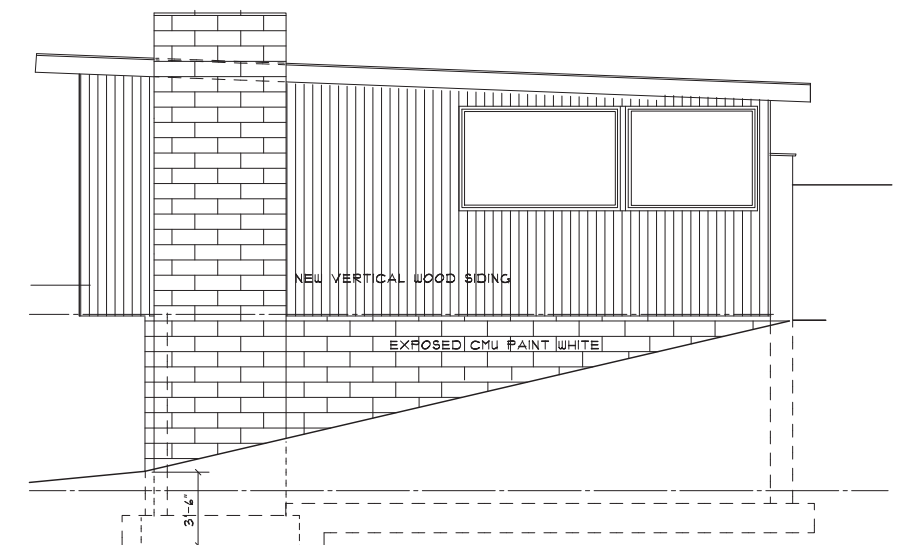

EAST ELEVATION

SCALE: 1/4"=1'-0"

REVISIONS	1	1/25/22 - NEW SECTION A-S NEW BRICK SITES + PATIO/ MOVED PRIV. FENCE as per eng. dpt., 401 - ron usinger, ass. village eng. 12/28/22	ALL WORK SHOWN ON THESE DRAWINGS SHALL COMPLY WITH THE 2020 NEW YORK STATE RESIDENTIAL CODE AND THE NEW YORK STATE 2020 ENERGY CODE	 P.C.D. ASSOCIATES DESIGN CONSULTANTS 24 HAWLEY ROAD EXTENSION DANBURY, CT. 06811	S A C P.E. STEVEN A. COSTA, P.E. CONSULTING ENGINEER 154 PALISADE AVENUE YONKERS, NEW YORK 10703	JOB TITLE ALTERATION TO EXISTING RESIDENCE AND NEW DETACHED GARAGE/ POOL HOUSE 15 FINNEY FARM ROAD CROTON ON HUDSON, NEW YORK DRAWING TITLE AS BUILT	6/28/22	SHEET NO.
							DRAWN BY	AB2
							PC	
							CHECKED BY	
							SAC	
			AS NOTED					