

Village of **Croton-on-Hudson**



Engineering Department
Stanley H. Kellerhouse Municipal Building
One Van Wyck Street
Croton-on-Hudson, NY 10520-2501
Tel: 914-271-4783
engineering@crotononhudson-ny.gov

Application for Accessory Apartment Permit

(Form # Eng-\$230-41)
(Revised 12 2022)

Application Date: 8/31/2024

Application #: 20240443

Property Information: Section: _____ Block: _____ Lot: _____
Property Location (street address): 10 Hudson Street, Croton-on-Hudson.
Zoning District (check one): ☐ RA-5 ☐ RA-9 ☐ RA-25 ☐ RA-40 ☐ RA-60 ☐ RA-5 ☐ RB ☐ WDD

Property Owner:

Last Name: PESAVENTO First Name: Bruno MI: _____
Trust/Corporation/LLC: _____
Address: 10 Hudson Street
Address: Croton-on-Hudson, NY, 10520
Phone #: _____ Cell #: _____ E-mail: _____

Type of Ownership: Check one type of ownership below and complete information:

☒ Sole Ownership ☐ Joint Tenancy ☐ Tenants in Common ☐ Tenancy in the Entirety
Does the owner of the types listed above reside in one of the dwelling units as their primary residence?
YES ☒ NO ☐ If yes, please provide documentation and complete the following:

Owner Information (same as above ☐):

Last Name: PESAVENTO First Name: Bruno MI: _____
Address: 10 Hudson St.
Address: Croton-on-Hudson NY 10520
Phone #: _____

- ☐ **LLC or Corporation:** does the majority owner of the membership interest or share interest reside in one of the dwelling units as their primary residence? YES ☐ NO ☐
If yes, please provide documentation showing that the member or shareholder residing in the dwelling is the owner of the majority of the membership interest/share interest in the LLC or Corporation that owns the premises and complete the following:

Majority Owner Information:

Last Name: N/A First Name: _____ MI: _____
Current Address: _____
Address: _____
Phone #: _____ Cell #: _____ E-mail: _____

- ☐ **Trust:** does the Beneficiary or Grantor reside in one of the dwelling units as their primary residence?
YES ☐ NO ☐ If yes, please provide Trust documentation showing that the individual below is the beneficiary or grantor and complete the following:

Trust Grantor or Beneficiary Information:

Last Name: _____ First Name: _____ MI: _____
Address: N/A
Address: _____
Phone #: _____ Cell #: _____ E-mail: _____

The granting of permit for Accessory Apartment is a Type II Action under SEQR.

Please answer the following:

- Is this application for an existing accessory apartment? YES ☒ NO ☐ (Existing 2 family)
- Number of existing dwelling units on property. 2
- Is this building a single-family detached dwelling? YES ☒ NO ☐ Previous 2 Family -
- Is there an existing Professional Office or Bed & Breakfast in the dwelling? YES ☐ NO ☒
- Is the required survey of the property attached? YES ☒ NO ☐
- Are required scaled floor plans for the entire dwelling showing the proposed accessory apartment attached? YES ☒ NO ☐
- What is the square footage of the entire habitable floor area of the existing single family detached dwelling? 1218
- What is the square footage of the habitable floor area of the accessory apartment (400 sq. ft. min., 750 sq. ft. maximum or no more than 33% of habitable floor area of the dwelling)? 508
- Are any additions to the single-family dwelling proposed? YES ☐ NO ☒ (41%)
- If additions to the dwelling are proposed, are the required scaled plans (floor plans and elevation plans) for the addition attached? YES ☐ NO ☐ (N/A)
- If an addition is proposed, does the building maintain the character and appearance of a single-family dwelling? YES ☒ NO ☐
(elevation views of the existing building with the proposed addition shall be provided along with pictures of the existing building)
- Does the accessory apartment have a separate entrance not observable from the street? YES ☐ NO ☒
- Is there a single entrance with a foyer or hallway to the two dwelling units? YES ☐ NO ☒
- Is the residence currently connected to the Village's sanitary sewer units? YES ☒ NO ☐
- Number of existing off street parking spaces (min of 3 required). 3
- Does the off-street parking need to be expanded to satisfy the 3 required off street parking spaces? YES ☐ NO ☒ If yes, show proposed additional off-street parking on survey or site plan. Note: in RA5 zoning district, expansion of off-street parking is not permitted.
- Does the lot size conform to the requirements of the zoning district in which the lot is located YES ☒ NO ☐ if no has a variance been granted by the Zoning Board of appeals. YES ☐ NO ☐ NA ☐

Requirements/conditions

- o Planning Board Approval (please contact Planning Bd. Secretary for meeting dates)
- o Approval runs with the property owner.
- o Scaled floor plans with floor areas labeled shall be submitted
- o Please be advised that written notification by the Village will be given to property owners within 100 ft. of subject property prior to the Planning Board meeting.
- o Owner must occupy at least one of the dwelling units as their primary residence.
- o Approval will become null & void within ninety (90) days of any of the following events:
 - death of all property owners
 - change in residence of all property owners who were residing in the house when permit was granted(Note: The Planning Board may grant a 90-day extension for good cause)
- o Only one (1) accessory apartment per property containing a single-family detached dwelling
- o No accessory apartment shall be permitted on premises with a Professional Office or Bed & Breakfast use
- o Accessory apartment permitted only within the main structure
- o Habitable floor area shall be no less than 400 sq. ft. and no greater than the lesser of 750 sq. ft. or 33.3% of the habitable floor area of the dwelling.
- o The building shall maintain the character and appearance of a single-family dwelling.
- o If the premises are not served by the Village sewer system, Westchester Co. Dept. of Health approval required.
- o Please be advised that all necessary documents must be submitted (8 copies and PDF) and fee must be paid prior to review by the Planning Board.

I, certify that the above information is accurate, and I am the property owner or authorized by the owner to file this application on their behalf and that I will indemnify and hold the Village harmless against any damage or injury that may be caused by or arise out of any entry onto the property in connection with the processing of the application.

Bruno Pesavento
Applicant's Name (please print)

Bruno Pesavento
Applicant's Signature

8/31/2024
Date

Corporate/Trust Name (please print)

Authorized Signature & Title

Date

FOR VILLAGE USE ONLY:

Fee \$ 250.00

Fee Paid (date): 8/30/24

Received by: KS

APPROVED BY: _____

TITLE: _____

DATE: _____

Account review: ☐ (zero Bal)


☐ (other) _____

Date: _____

PB Notice date: _____

Meeting date: _____

Approval date: _____

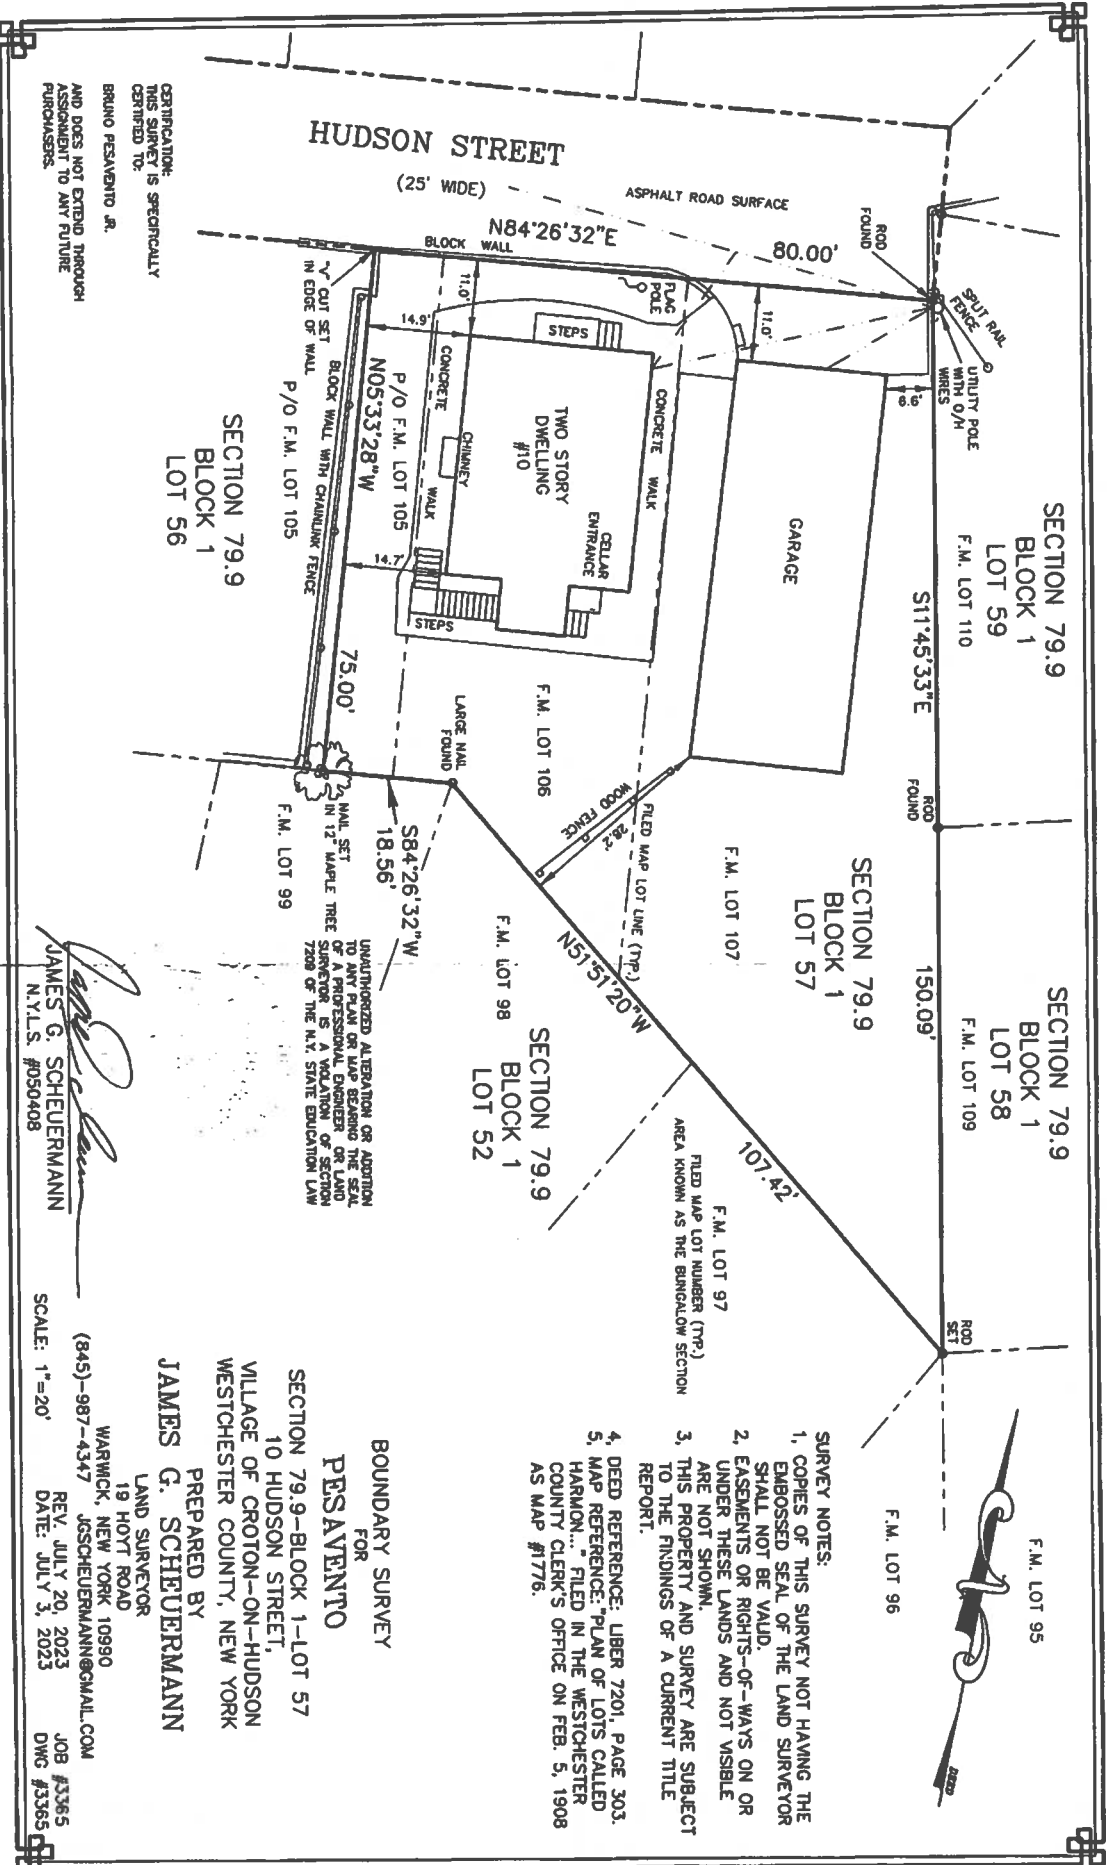

CERTIFICATION:
THIS SURVEY IS SPECIFICALLY
CERTIFIED TO:
BRUNO PESAVENTO JR.
AND DOES NOT EXTEND THROUGH
ASSIGNMENT TO ANY FUTURE
PURCHASERS.

James G. Scheuermann
JAMES G. SCHEUERMANN
N.Y.L.S. #050408


SCALE: 1"=20'

(845)-987-4347
REV. JULY 20, 2023
DATE: JULY 3, 2023
JGSCHUEMANN@GMAIL.COM
JOB #1365
DWG #3365

SECTION 79.9-BLOCK 1-LOT 57
10 HUDSON STREET,
VILLAGE OF CROTON-ON-HUDSON
WESTCHESTER COUNTY, NEW YORK
PREPARED BY
JAMES G. SCHEUERMANN
LAND SURVEYOR
19 HOYT ROAD
WARWICK, NEW YORK 10980


BOUNDARY SURVEY
FOR
PESAVENTO

- SURVEY NOTES:
1. COPIES OF THIS SURVEY NOT HAVING THE EMBOSSED SEAL OF THE LAND SURVEYOR SHALL NOT BE VALID.
 2. EASEMENTS OR RIGHTS-OF-WAYS ON OR UNDER THESE LANDS AND NOT VISIBLE ARE NOT SHOWN.
 3. THIS PROPERTY AND SURVEY ARE SUBJECT TO THE FINDINGS OF A CURRENT TITLE REPORT.
 4. DEED REFERENCE: LIBER 7201, PAGE 303.
 5. MAP REFERENCE: "PLAN OF LOTS CALLED HARMON..." FILED IN THE WESTCHESTER COUNTY CLERK'S OFFICE ON FEB. 5, 1908 AS MAP #1776.

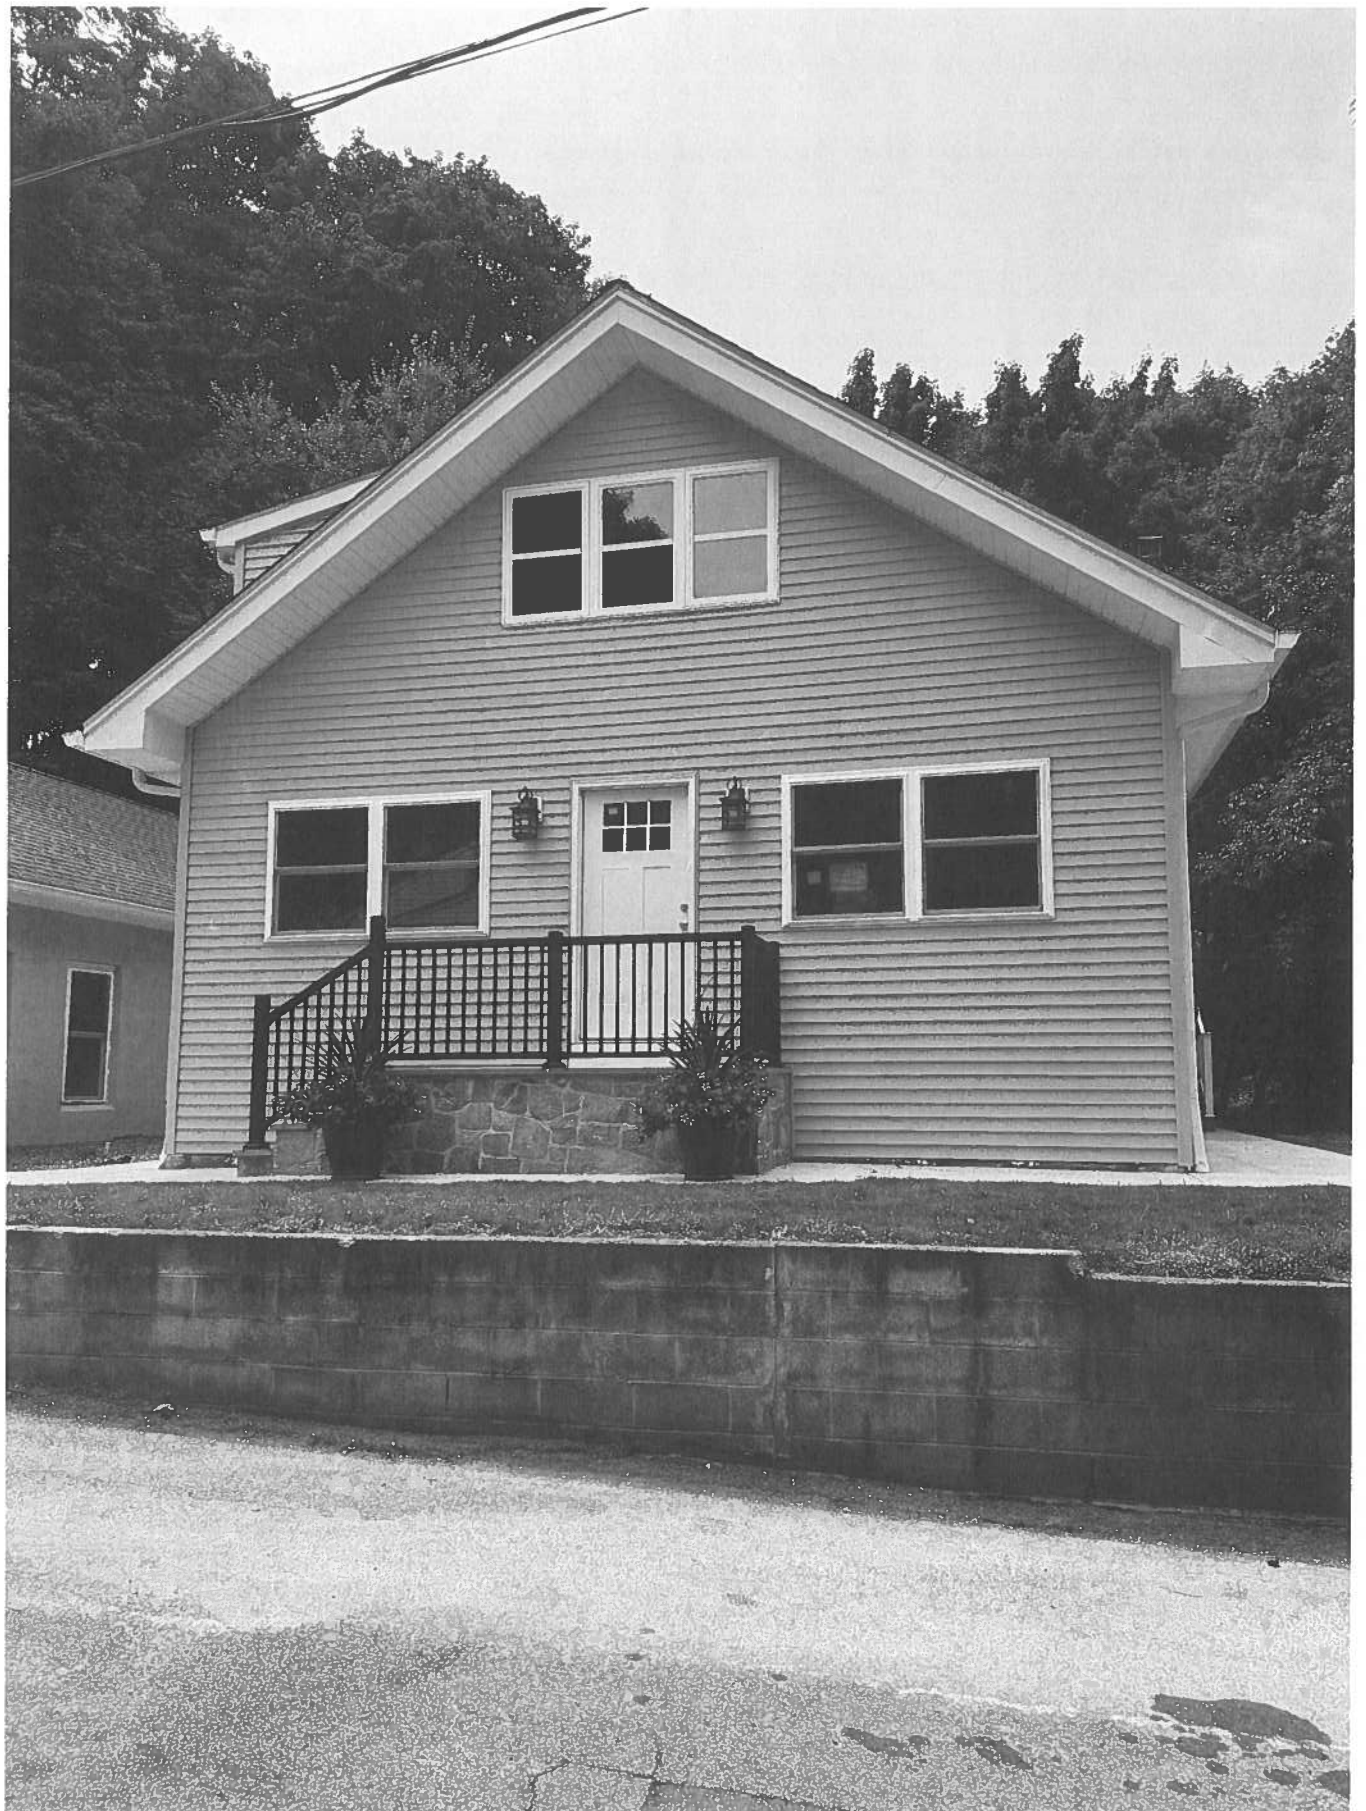




10 Hudson St.
1st Floor

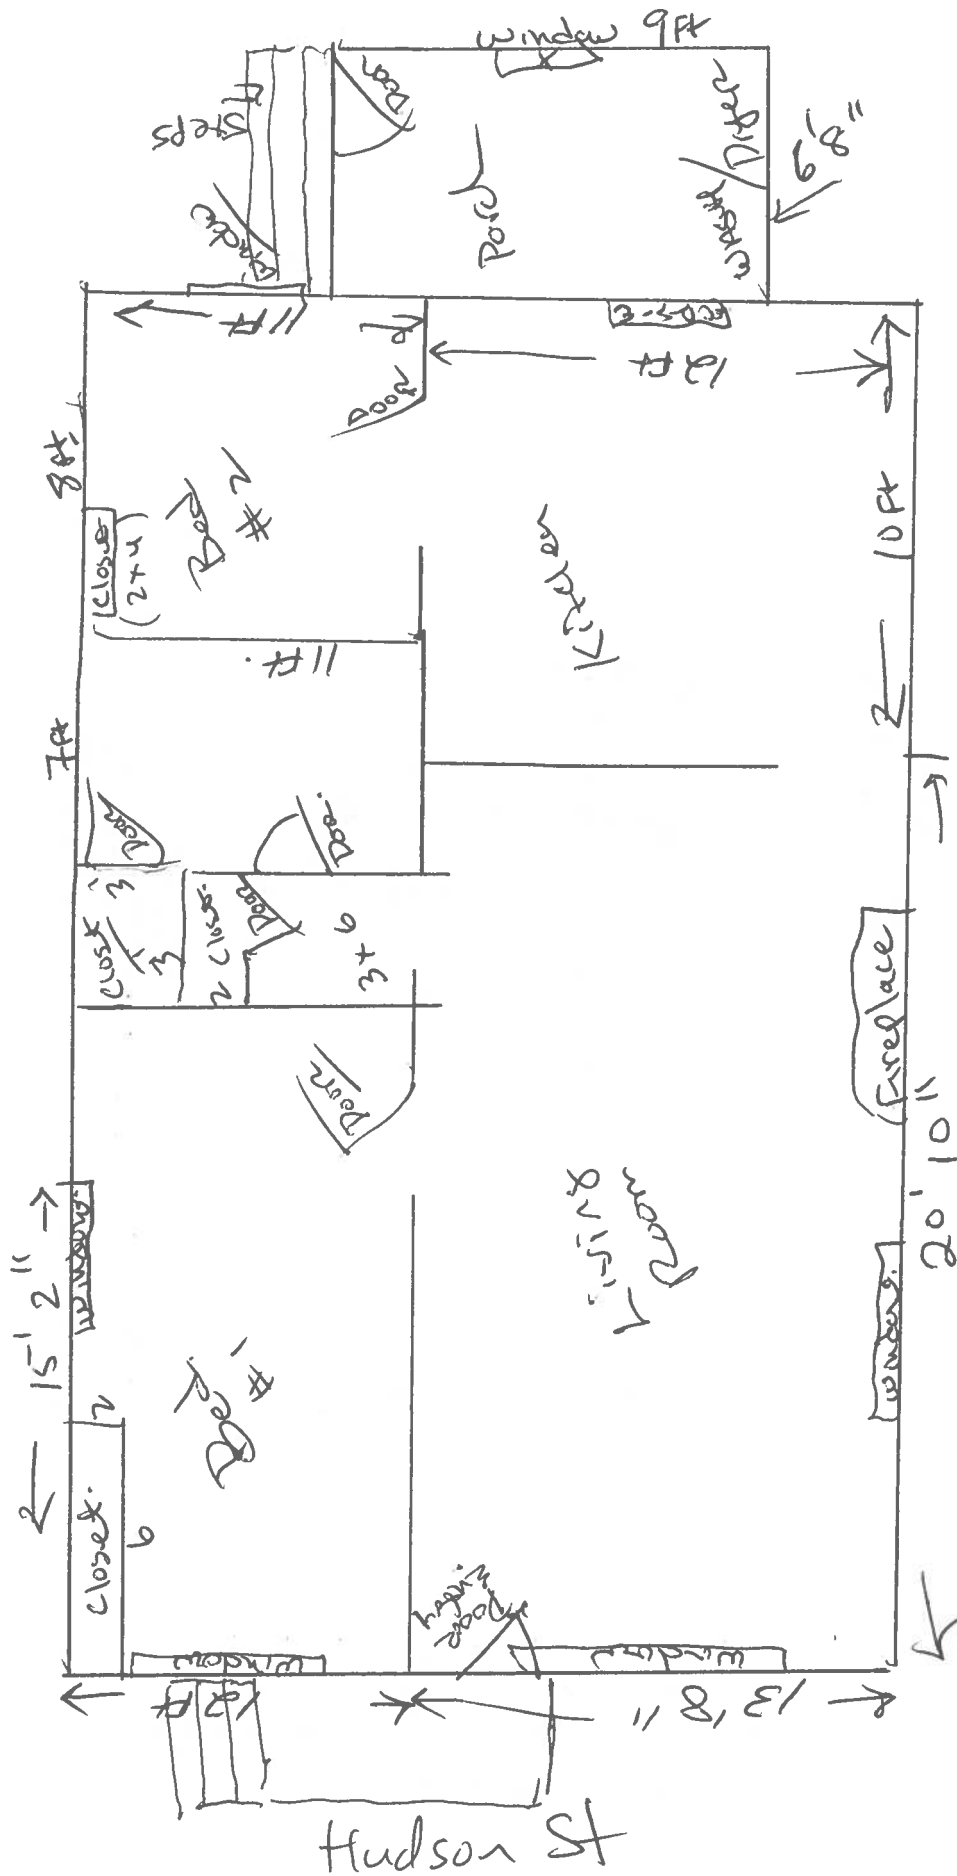

10 Hudson Street 2nd Floor

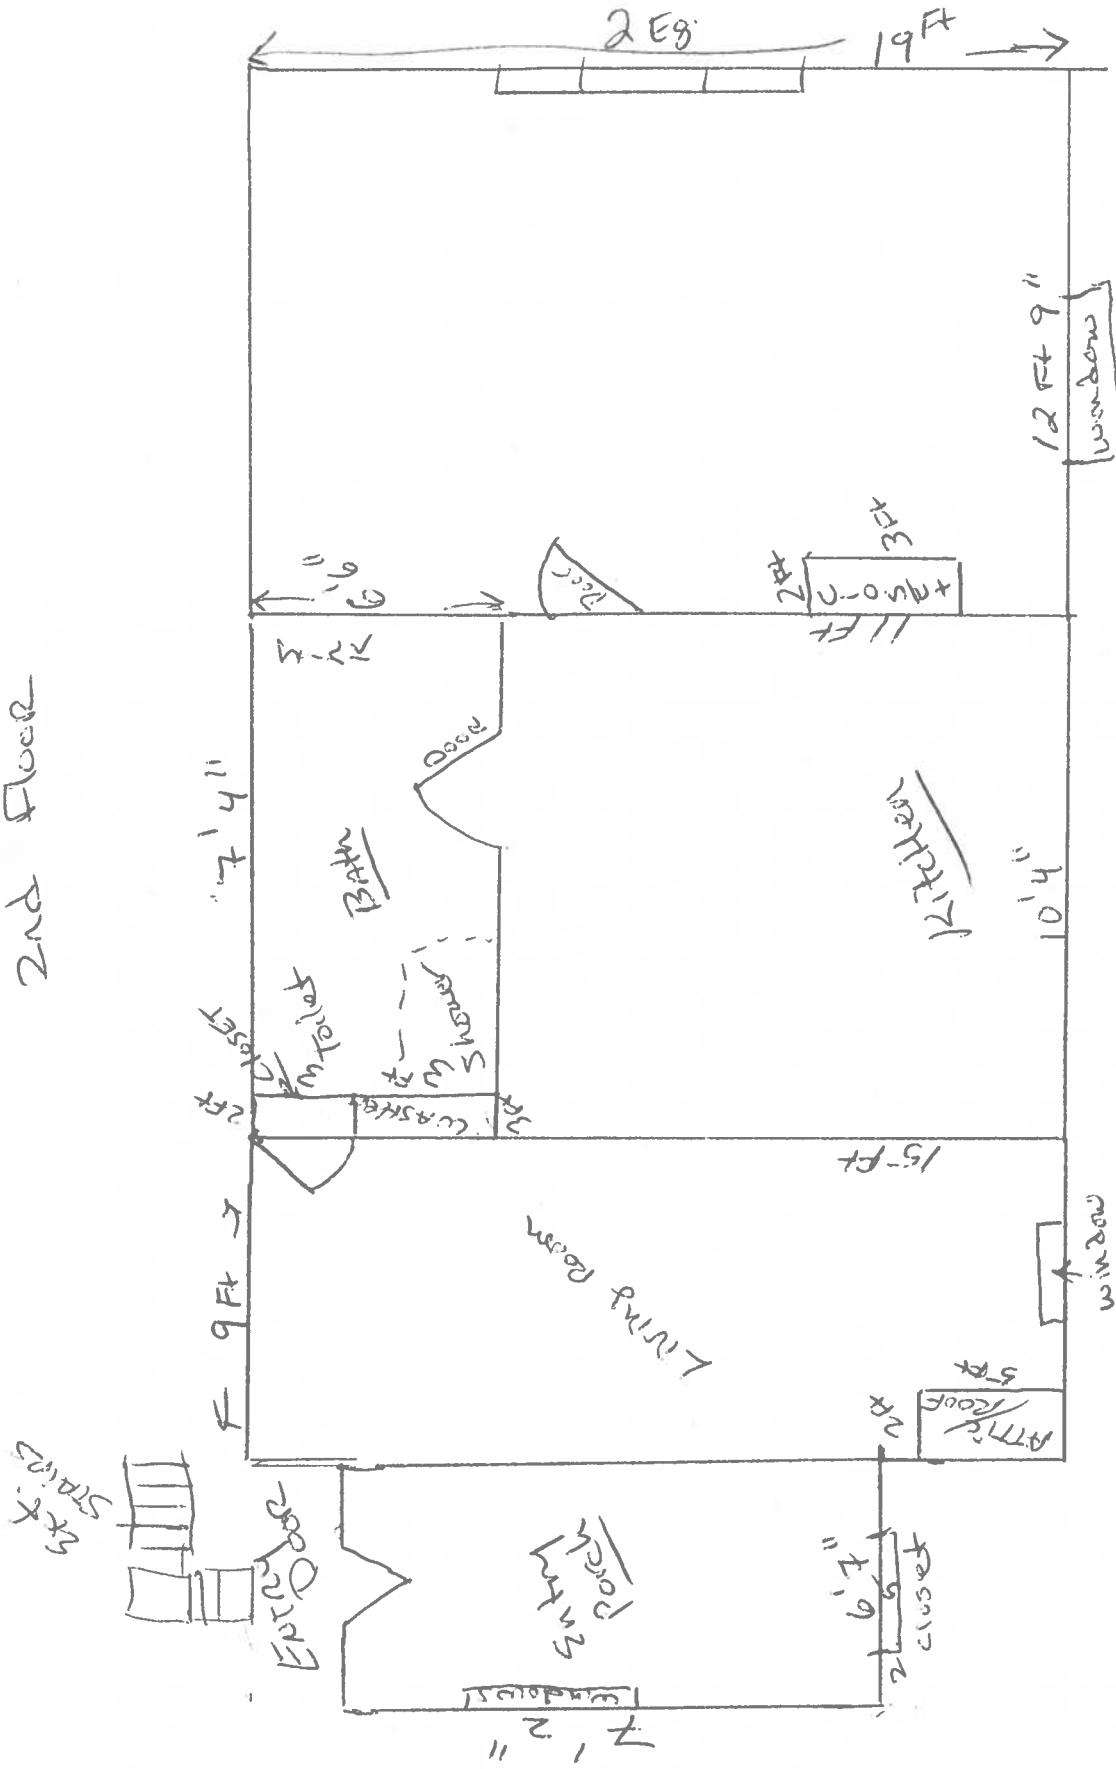

* Smoke & carbon monoxide Detectors Installed Per code

10 Hudson St
Side Entrance



RECEIVED
SEP 04 2024
Engineers Office

10 Hudson St
Side entrance.



RECEIVED
SEP 04 2024
Engineers Office