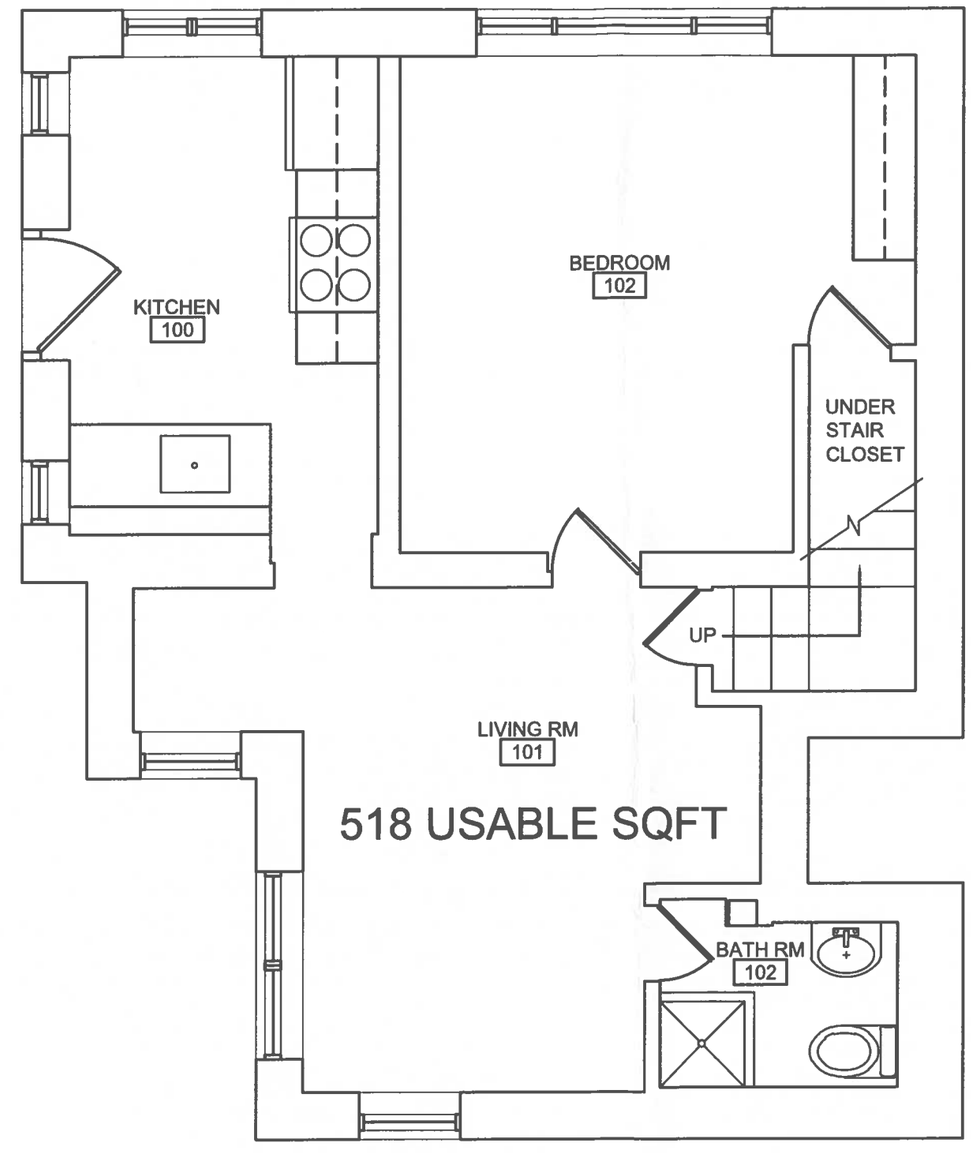


1 / A-1 AS-BUILT BASEMENT PLAN

SCALE: 1/4"=1'-0"

IT IS A VIOLATION FOR ANY PERSON, UNLESS HE OR SHE IS ACTING UNDER THE DIRECTION OF A LICENSED PROFESSIONAL ENGINEER OR LAND SURVEYOR, TO ALTER AN ITEM IN ANY WAY. IF AN ITEM BEARING THE SEAL OF AN ENGINEER OR LAND SURVEYOR IS ALTERED, THE ALTERING ENGINEER OR LAND SURVEYOR SHALL AFFIX TO THE ITEM HIS OR HER SEAL AND THE NOTATION "ALTERED BY" FOLLOWED BY HIS OR HER SIGNATURE AND THE DATE OF SUCH ALTERATION, AND A SPECIFIC DESCRIPTION OF THE ALTERATION


LEWIS C ROANE
ARCHITECT
3 WINDSOR ROAD
CROTON-ON-HUDSON, NEW YORK
TEL (914) 330-1802
LEWISROANEDESIGN@GMAIL.COM

REV	DATE	ISSUE
	10/03/2026	ISSUED FOR FILING

PROJECT NAME
AS-BUILT CONDITIONS:
ROSS RESIDENCE
110 MAPLE AVE
CROTON ON HUDSON, NY 10520

DRAWING TITLE
EXISTING CONDITION PLAN

DRAWING NO
A-1

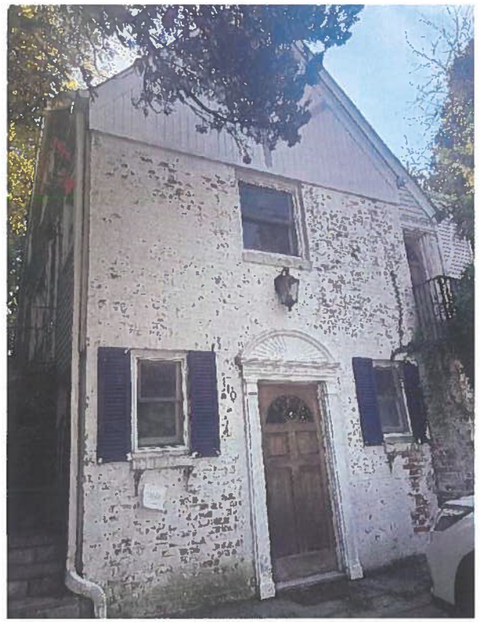


A




B



C

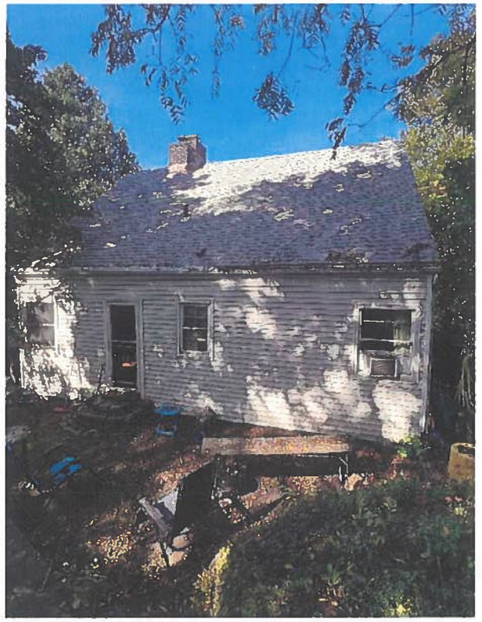


D

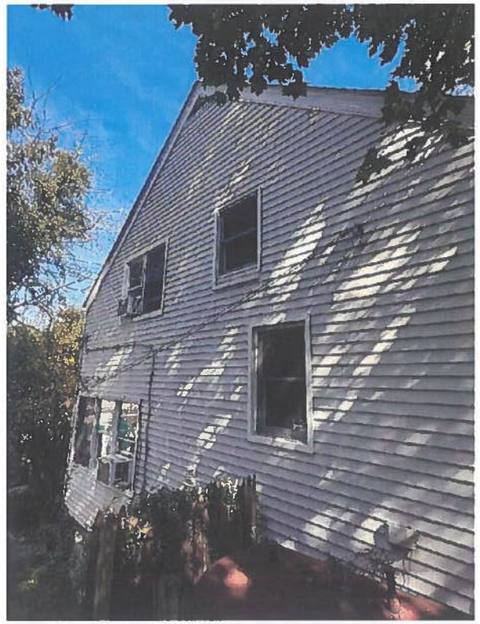

E



F

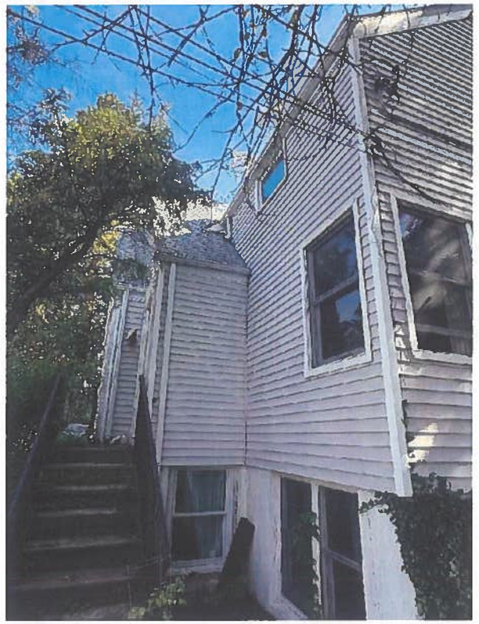

G



KEY PLAN

IT IS A VIOLATION FOR ANY PERSON, UNLESS HE OR SHE IS ACTING UNDER THE DIRECTION OF A LICENSED PROFESSIONAL ENGINEER OR LAND SURVEYOR, TO ALTER AN ITEM IN ANY WAY. IF AN ITEM BEARING THE SEAL OF AN ENGINEER OR LAND SURVEYOR IS ALTERED, THE ALTERING ENGINEER OR LAND SURVEYOR SHALL AFFIX TO THE ITEM HIS OR HER SEAL AND THE NOTATION "ALTERED BY" FOLLOWED BY HIS OR HER SIGNATURE AND THE DATE OF SUCH ALTERATION, AND A SPECIFIC DESCRIPTION OF THE ALTERATION

LEWIS C ROANE
ARCHITECT
3 WINDSOR ROAD
CROTON-ON-HUDSON, NEW YORK
TEL (914) 330-1802
LEWISROANEDESIGN@GMAIL.COM

REV	DATE	ISSUE
	10/03/2026	ISSUED FOR FILING

PROJECT NAME
AS-BUILT CONDITIONS:
ROSS RESIDENCE
110 MAPLE AVE
CROTON ON HUDSON, NY 10520

DRAWING TITLE
EXISTING HOUSE PHOTOS

DRAWING NO
S-1